



Audio Visual Low Level Design Cover Sheet & Drawing Register

Client: Transport NSW

Project: Transport NSW 231 Elizabeth St,
06.MR.14 Video Wall v3

Types: Audio Visual Schematic System

DRAWING SET REGISTER			
Drawing No	Description	Rev	Note
PAVS-AV-TRP-LD-100	Cover Sheet & Drawing Register	D	
PAVS-AV-TRP-LD-101	Scope of Works	A	
PAVS-AV-TRP-LD-102	06.MR.14 Video Wall - In stock items	C	
PAVS-AV-TRP-LD-103	Rack Layout	C	

NOTES:
THE INFORMATION CONTAINED IN THIS DOCUMENT IS PROPRIETARY TO PRO AV SOLUTIONS (NSW) THIS DOCUMENT IS PREPARED FOR A SPECIFIC SITE AND INCORPORATES CALCULATIONS BASED ON DATA AVAILABLE AT THIS TIME. BY ACCEPTING AND USING THIS DOCUMENT, THE RECIPIENT AGREES TO PROTECT ITS CONTENTS FROM FURTHER DISSEMINATION, OTHER THAN THAT WITHIN THE ORGANIZATION NECESSARY TO EVALUATE SUCH SPECIFICATION) WITHOUT THE WRITTEN PERMISSION OF PRO AV SOLUTIONS (NSW) THE CONTENTS OF THIS DOCUMENT ARE NOT TO BE REPRODUCED OR COPIED IN WHOLE OR IN PART WITHOUT THE WRITTEN PERMISSION OF PRO AV SOLUTIONS (NSW).

LINES AND CABLE IDS

8723 CONTROL CABLE	C001
CAT 6A ETHERNET CABLE	D001
CRESNET CABLE	W001
CAT 6A VIDEO TRANSMISSION	V001
COMPONENT CABLE	I001
COMPOSITE CABLE	J001
HEARING LOOP FEEDER CABLE	F001
DIGITAL (HDMI/DVI/DISPLAY PORT) CABLE	H001
RG8U CABLE	T001
RG11 CABLE	B001
RGBHV / 5-CORE MINI COAXIAL CABLE	G001
FIGURE 8 SPEAKER CABLE	S001
S-VIDEO CABLE	Q001
8723 AUDIO CABLE	A001
USB 2.0 CABLE	U3001
USB 3.0 CABLE	L001
HEARING LOOP TAPE	P001
LOW VOLTAGE POWER CABLE	M001
MULTI-CORE MICROPHONE CABLE	R001
RG6 CABLE	UC001
USB C CABLE	N001
SINGLE-MODE FIBRE CABLE	O001
MULTI-MODE FIBRE CABLE	Y001
PROPRIETARY CABLE	IC001
RACK INTERCONNECT CABLE	

LOCATION COLOURS

WALL	TABLE
CEILING	LECTERN
FLOOR	MOBILE
RACK	CREDENZA
FREE STAND	BIO BOX

COMMS PORTS

AV LAN	BMS LAN
CLIENT LAN	DANTE/AES LAN
PSTN LINE	SVSI/NVX LAN

CONTROL PORTS

SERIAL (232, 485)
INFRARED
RELAY
I/O
PROPRIETARY LINK

GENERAL ARRANGEMENT SYMBOLS

SINGLE SWITCHED GENERAL POWER OUTLET
DOUBLE SWITCHED GENERAL POWER OUTLET
SINGLE CAT 6 DATA OUTLET
DOUBLE CAT 6 DATA OUTLET
MATV OUTLET
65MM CORE HOLE
AV RACK
FLUSH MOUNTED CEILING SPEAKER
SURFACE MOUNTED SPEAKER
DATA PROJECTOR
WALL MOUNTED LCD DISPLAY
CEILING MOUNTED LCD DISPLAY
TROLLEY MOUNTED LCD DISPLAY
MOTORISED PROJECTION SCREEN
DESKTOP MOUNTED DISPLAY
PTZ CAMERA MOUNT
TABLE BOX INPUT
FLOOR BOX INPUT/OUTPUT
INPUT PLATE
TOUCH CONTROL INTERFACE
ROOM BOOKING PANEL
CONTROL KEYPAD
INFRARED HEARING AUGMENTATION
ANTENNA
GOOSENECK MICROPHONE
BOUNDARY MICROPHONE
CEILING ACCESS PANEL
CEILING MICROPHONE
CEILING MICROPHONE ARRAY



D	15/11/21	For construction issue.	BM
C	09/11/21	For construction issue - Changes as per Konnectus review comments.	BM
B	13/09/21	For construction issue.	BM
A	13/08/21	For construction issue.	BM
REV	DATE	REVISION DESCRIPTION	DRAWN

STATUS:
FOR CONSTRUCTION



Unit 8, 25 Frenchs Forest Rd
Frenchs Forest
NSW 2086
Ph: (02) 8978 1700
Fax: (02) 9907 2077
www.proAVsolutions.com.au

CLIENT:
Transport NSW



PROJECT:
Transport NSW 231 Elizabeth St, 06.MR.14
Video Wall v3

TITLE:
Cover Sheet & Drawing Register

SHEET SIZE:	SCALE:	DRAWN:	CHECKED:
A3	N/A	BM	VG

JOB NO.:
21/6097

DRAWING NO.: PAVS-AV-TRP-LD-100	REV: D
------------------------------------	-----------

Scope of Works:

06.MR.14 Video Wall - In stock items

Note** displays and brackets swapped to in stock items.
Devices swapped:
3x WMN55VDXY replaced with LVS1U

Video wall as per Konnectus specification

- Note:
- Equipment to be stored in existing central rack.
 - Works priced in business hours.
 - Electrical works priced outside of business hours

NOTES:

THE INFORMATION CONTAINED IN THIS DOCUMENT IS PROPRIETARY TO PRO AV SOLUTIONS (NSW) THIS DOCUMENT IS PREPARED FOR A SPECIFIC SITE AND INCORPORATES CALCULATIONS BASED ON DATA AVAILABLE AT THIS TIME. BY ACCEPTING AND USING THIS DOCUMENT, THE RECIPIENT AGREES TO PROTECT ITS CONTENTS FROM FURTHER DISSEMINATION, OTHER THAN THAT WITHIN THE ORGANIZATION NECESSARY TO EVALUATE SUCH SPECIFICATION) WITHOUT THE WRITTEN PERMISSION OF PRO AV SOLUTIONS (NSW) THE CONTENTS OF THIS DOCUMENT ARE NOT TO BE REPRODUCED OR COPIED IN WHOLE OR IN PART WITHOUT THE WRITTEN PERMISSION OF PRO AV SOLUTIONS (NSW).

A	08/11/21	For construction issue.	BM
REV	DATE	REVISION DESCRIPTION	DRAWN

STATUS:

FOR CONSTRUCTION



Unit 8, 25 Frenchs Forest Rd
Frenchs Forest
NSW 2086
Ph: (02) 8978 1700
Fax: (02) 9907 2077
www.proAVsolutions.com.au

CLIENT:
Transport NSW



PROJECT:
Transport NSW 231 Elizabeth St, 06.MR.14
Video Wall v3

TITLE:
Scope of Works

SHEET SIZE:	SCALE:	DRAWN:	CHECKED:
A3	N/A	BM	VG

JOB NO.:
21/6097


DRAWING NO.: PAVS-AV-TRP-LD-101	REV: A
------------------------------------	-----------

Transport NSW


06.MR.14 Video Wall - In stock items

THE INFORMATION CONTAINED IN THIS DOCUMENT IS PROPRIETARY TO PRO AV SOLUTIONS (NSW). THIS DOCUMENT IS PREPARED FOR A SPECIFIC SITE AND INCORPORATES CALCULATIONS BASED ON DATA AVAILABLE AT THIS TIME. BY ACCEPTING AND USING THIS DOCUMENT, THE RECIPIENT AGREES TO PROTECT ITS CONTENTS FROM FURTHER DISSEMINATION, (OTHER THAN THAT WITHIN THE ORGANIZATION NECESSARY TO EVALUATE SUCH SPECIFICATION) WITHOUT THE WRITTEN PERMISSION OF PRO AV SOLUTIONS (NSW). THE CONTENTS OF THIS DOCUMENT ARE NOT TO BE REPRODUCED OR COPIED IN WHOLE OR IN PART WITHOUT THE WRITTEN PERMISSION OF PRO AV SOLUTIONS (NSW).

AV RACK (OFE)

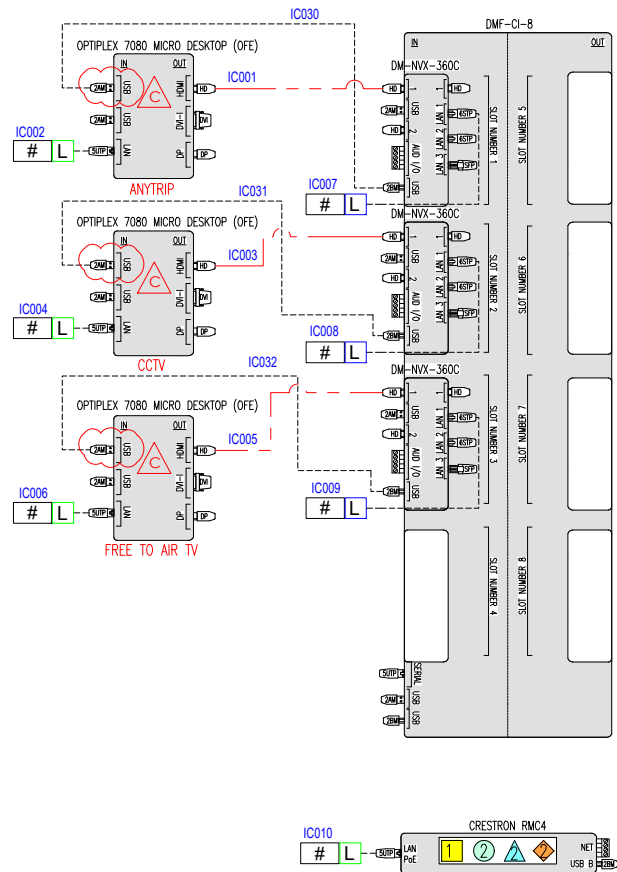

06.MR.14 VIDEO WALL

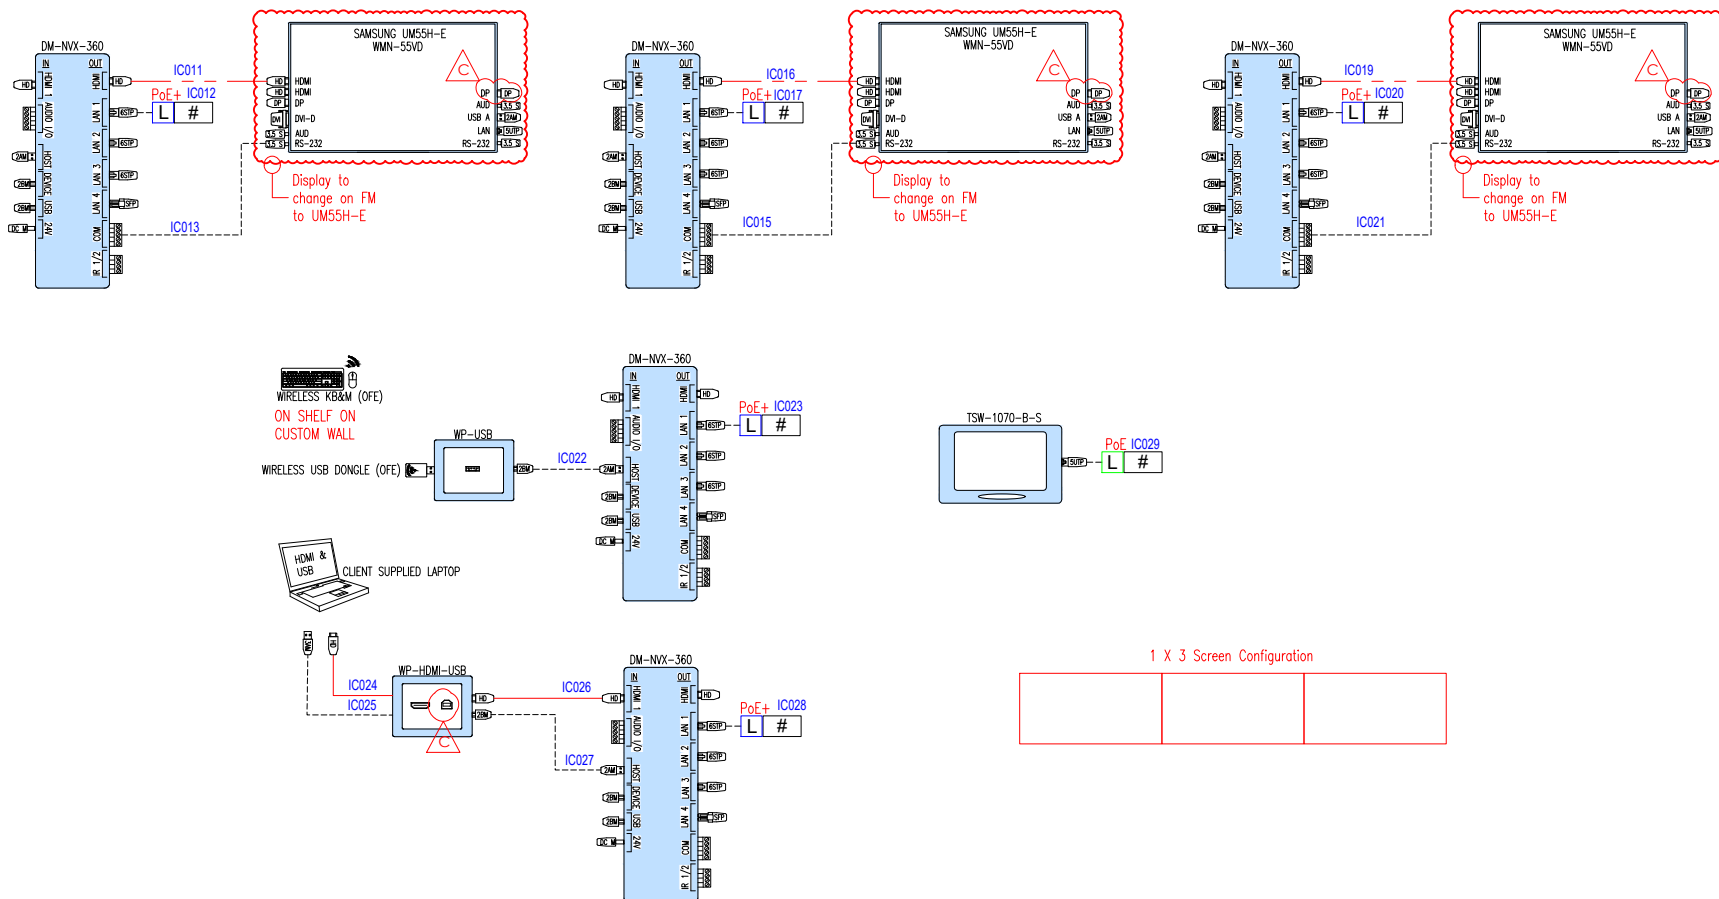

C	09/11/21	For construction issue - Changes as per Konnectus review comments.	BM
B	13/09/21	For construction issue.	BM
A	13/08/21	For construction issue.	BM
REV	DATE	REVISION DESCRIPTION	DRAWN

FOR CONSTRUCTION



Unit 8, 25 Frenchs Forest Rd
Frenchs Forest
NSW 2086
Ph: (02) 8978 1700
Fax: (02) 9907 2077
www.proAVsolutions.com.au

CLIENT:
Transport NSW



PROJECT:
Transport NSW 231 Elizabeth St, 06.MR.14
Video Wall v3

TITLE:
06.MR.14 Video Wall - In stock
items


SHEET SIZE:	SCALE:	DRAWN:	CHECKED:
A3	N/A	BM	VG

JOB NO.:
21/6097

DRAWING NO.:
PAVS-AV-TRP-LD-102

EV:
C

Transport NSW
06.MR.14 Video Wall - In stock items

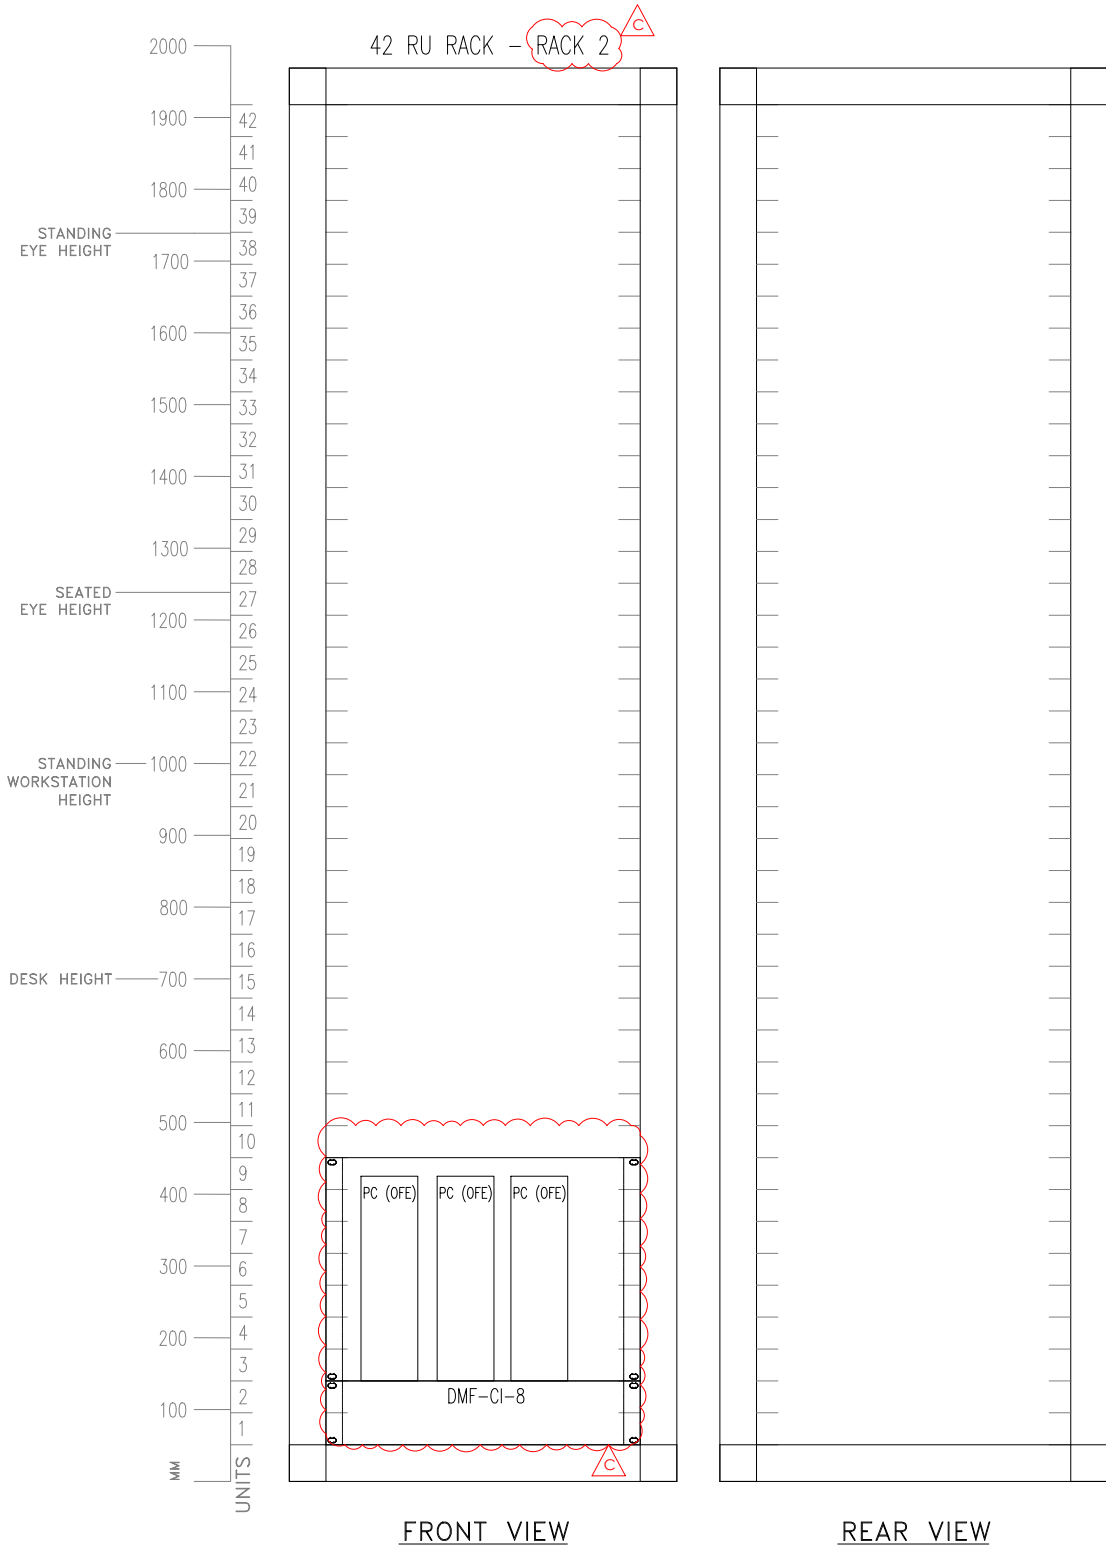

RESTRICTED SPACE	
CREDENZA	N
H(mm)	N/A
W(mm)	N/A
D(mm)	N/A
POWER LOAD	
10A	Y
15A	Y/N/NA
20A	Y/N/NA
BTU/hr:	
Partners = 3.412141633 x Power	
RACK ACCESSORIES	
SIDES:	Y/N/NA ADD 8mm
DOOR:	Y/N/NA ADD 16mm
CASTORS:	Y/N/NA ADD 72mm

NOTES:

THE INFORMATION CONTAINED IN THIS DOCUMENT IS PROPRIETARY TO PRO AV SOLUTIONS (NSW) THIS DOCUMENT IS PREPARED FOR A SPECIFIC SITE AND INCORPORATES CALCULATIONS BASED ON DATA AVAILABLE AT THIS TIME. BY ACCEPTING AND USING THIS DOCUMENT, THE RECIPIENT AGREES TO PROTECT ITS CONTENTS FROM FURTHER DISSEMINATION, OTHER THAN THAT WITHIN THE ORGANIZATION NECESSARY TO EVALUATE SUCH SPECIFICATION) WITHOUT THE WRITTEN PERMISSION OF PRO AV SOLUTIONS (NSW) THE CONTENTS OF THIS DOCUMENT ARE NOT TO BE REPRODUCED OR COPIED IN WHOLE OR IN PART WITHOUT THE WRITTEN PERMISSION OF PRO AV SOLUTIONS (NSW).

C	15/11/21	For construction issue.	BM
B	09/11/21	For construction issue - Changes as per Konnectus review comments.	BM
A	13/08/21	For construction issue.	BM
REV	DATE	REVISION DESCRIPTION	DRAWN

STATUS:

FOR CONSTRUCTION



Unit 8, 25 Frenchs Forest Rd
Frenchs Forest
NSW 2086
Ph: (02) 8978 1700
Fax: (02) 9907 2077
www.proAVsolutions.com.au

CLIENT:
Transport NSW



PROJECT:
Transport NSW 231 Elizabeth St, 06.MR.14
Video Wall v3

TITLE:
06.MR.14 Video Wall - In stock
items

SHEET SIZE:	SCALE:	DRAWN:	CHECKED:
A3	N/A	BM	VG

JOB NO.:
21/6097

DRAWING NO.: PAVS-AV-TRP-LD-102	REV: C
------------------------------------	-----------